



D4



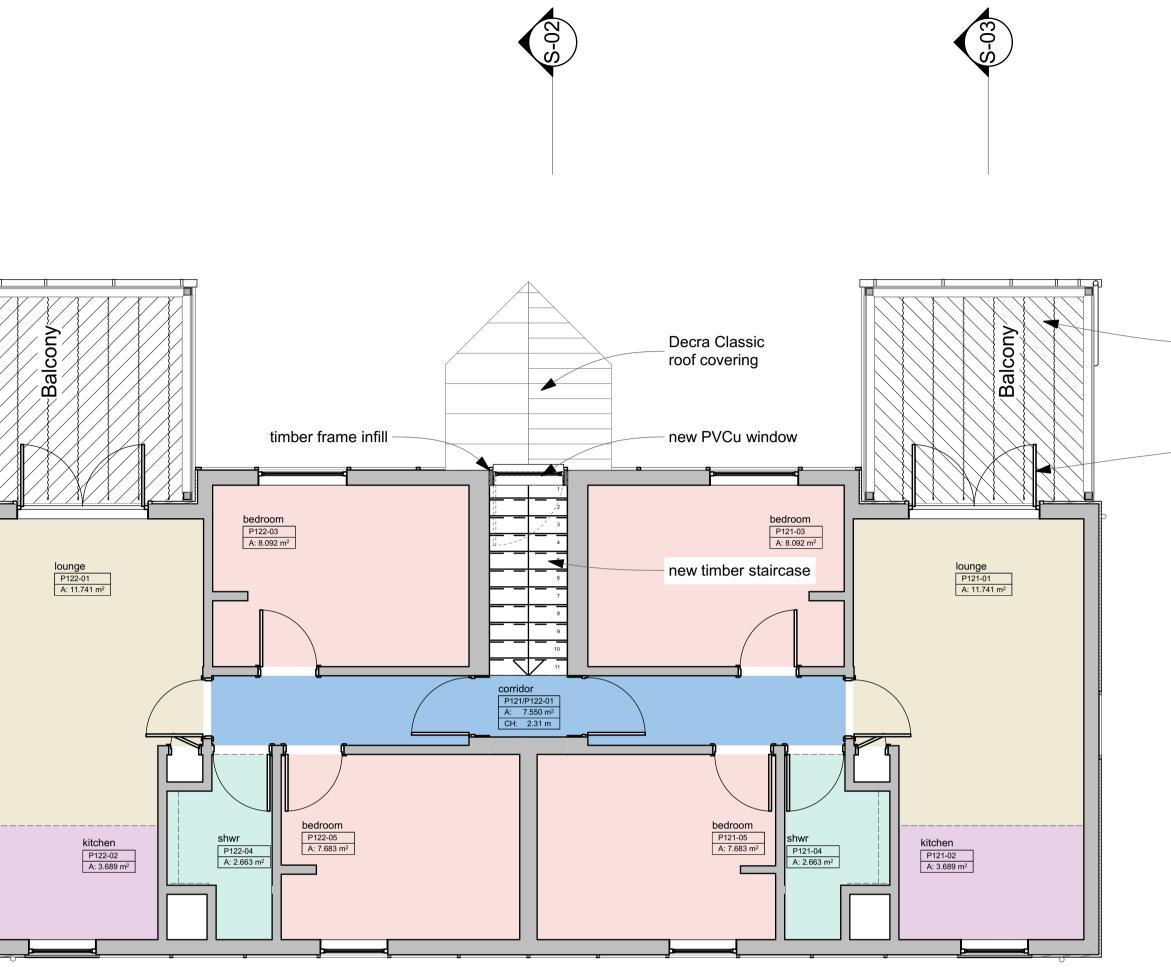

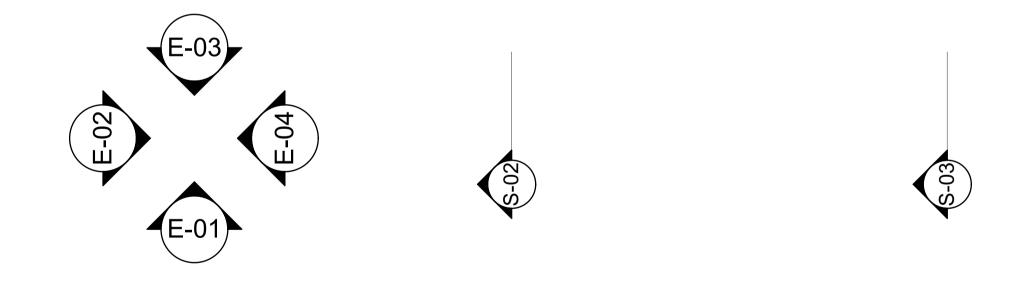

First Floor

<image/>
SURVEY DISCUSSION PURPOSES FEASIBILITY DRAWING CLIENT APPROVAL LPA PRE-APP DRAWING LPA SUBMISSION BUILDING REGULATIONS CONSTRUCTION ISSUE TENDER ISSUE REVISION
AS BUILT DRAWING This drawing describes the works relating to the external elements of the phase 2 works, including the internal staircase. Internal alterations and refurbishment are described on the drawings prepared by Newman Gauge
Rev Date Comment Client Approval A - Approved X B - Approved with Comments C - Do Not Use Client: Butlins Skegness Resort Roman Bank Skegness Lincolnshire PE25 1NJ PE25 1NJ
Orawn:DSDate:Aug '15Sheet Size:A1Scale:1:50
Sheet Description: D4 First Floor-Description-sheet 2 Sheet Number: Sheet Number: S2_171_407 41

first floor balcony as described on drawing — 402 in conjunction with structural engineers detail drawings

remove existing window, enlarge opening to receive pair of French PVCu doors with — 28 mm toughened double glazed units, 6 mm toughened inner and outer panes. adjust surround battens to suit new opening

1:50

Please consider the environmen